# zero carbon house

AS BUILT

**Sections E & F March 2008 1:50 at A2 103.08 D**
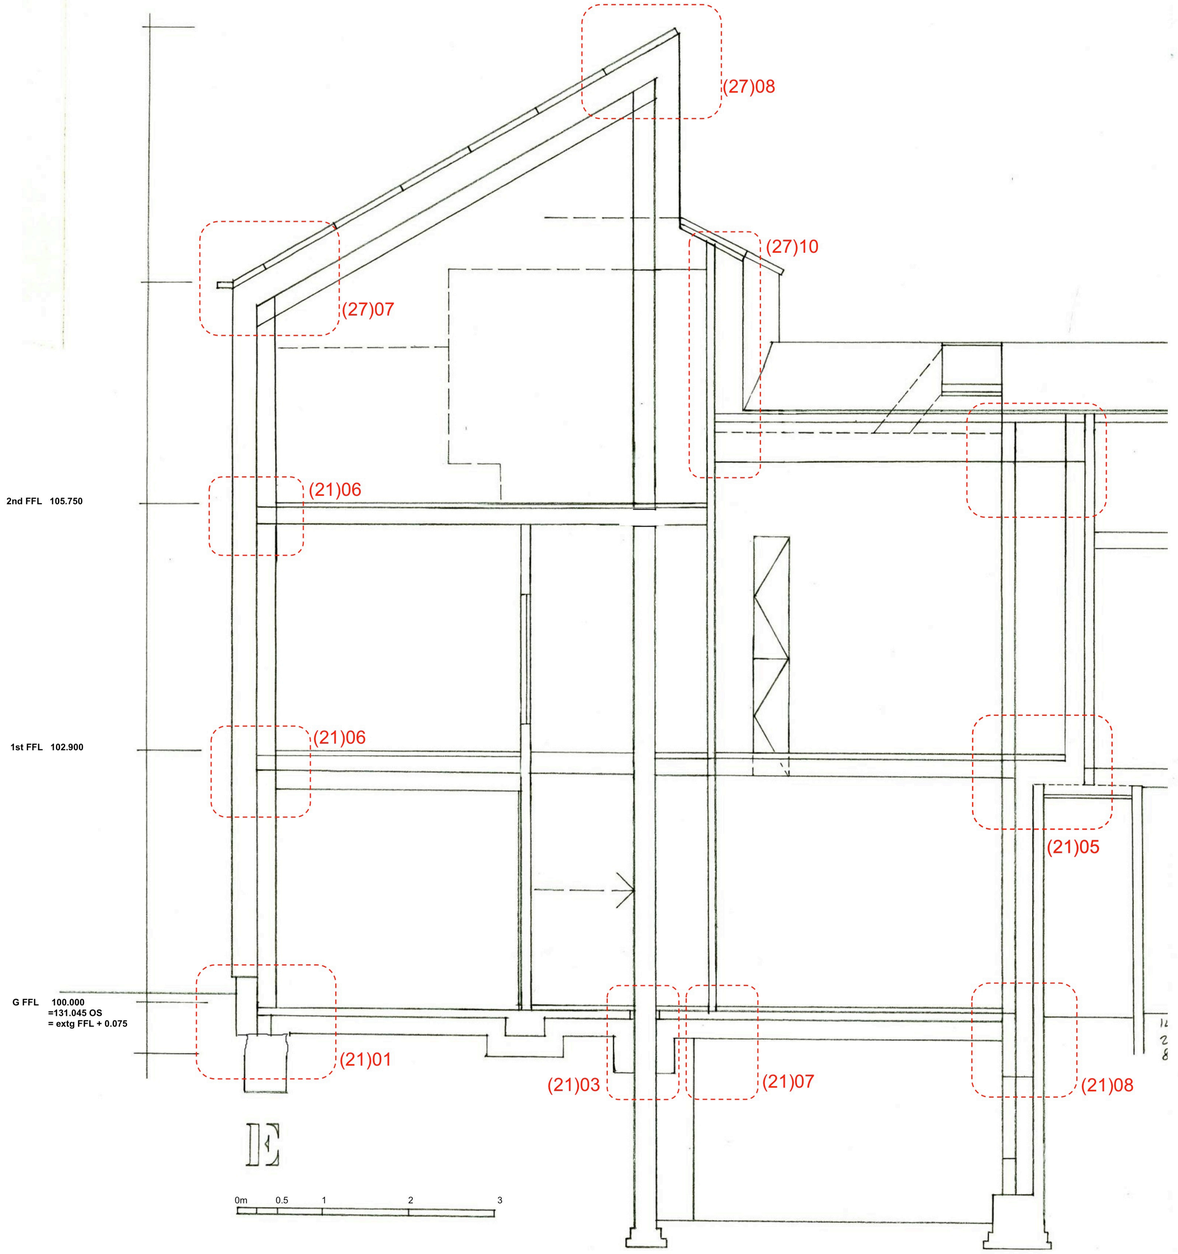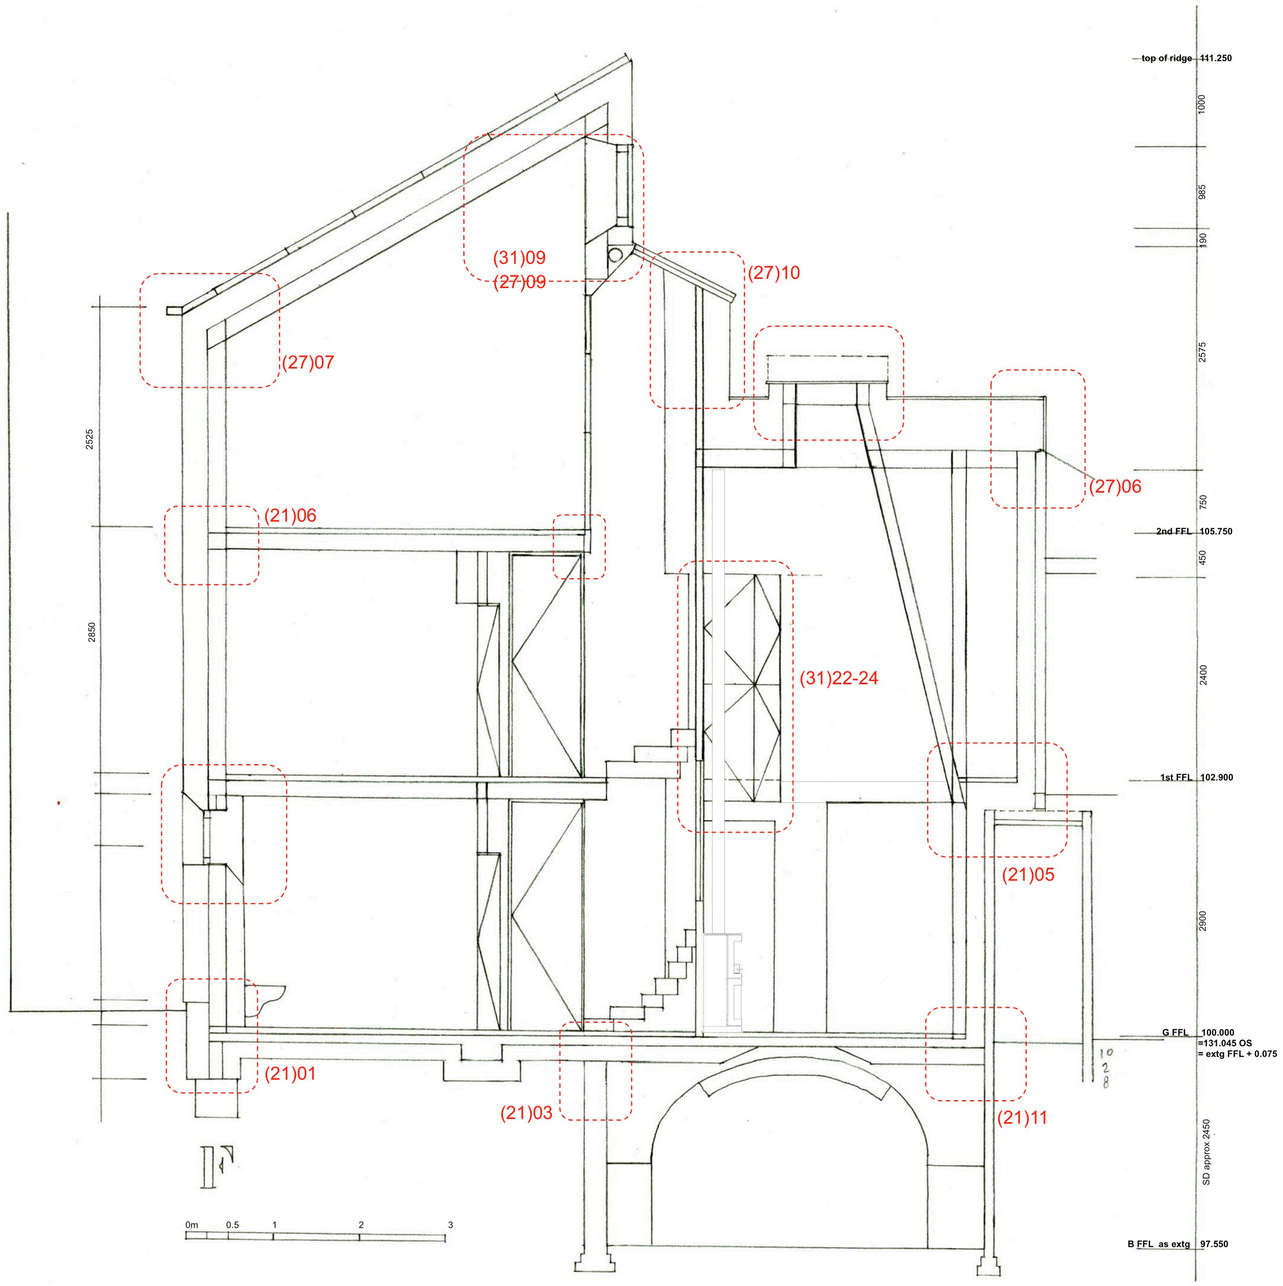
A: redrawn B:12.7.8: steels, details keyed C: 20.9.8: door ht in front bed reduced; foundation ht raised; wc window rev, slab thickening added. D:24.4.10: as built.